




50

Express Mail No.: EV336512866US Deposited: 06/20/2003
Title: METHOD OF COVERING A POTTED PLANT
Inventors: Donald E. Weder Filed: Herewith Examiner: F. Palo
Agent: Christopher W. Corbett SHEET 4 OF 22 Redline Drawings



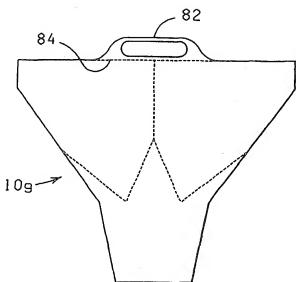


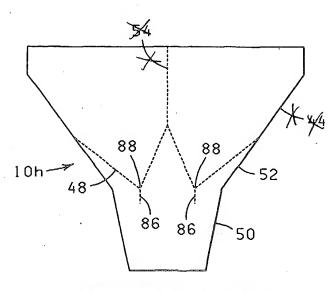


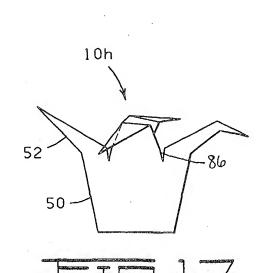



Express Mail No.: EV336512866US Deposited: 06/20/2003
Title: METHOD OF COVERING A POTTED PLANT
Inventors: Donald E. Weder
Filed: Herewith Examiner: F. Palo
Agent: Christopher W. Corbett
SHEET 5 OF 22


Deposited: 06/20/2003
Group: 3644
Examiner: F. Palo
Dkt. No.: 8403.888
Redline Drawings

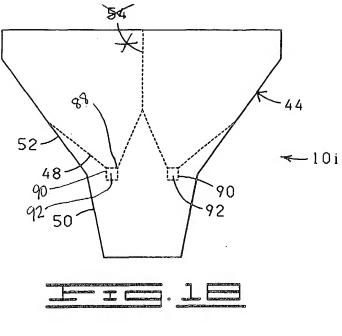


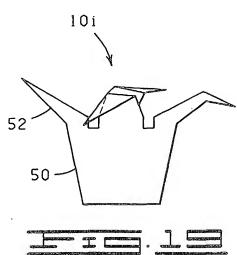


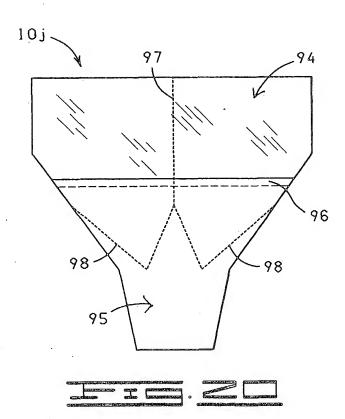


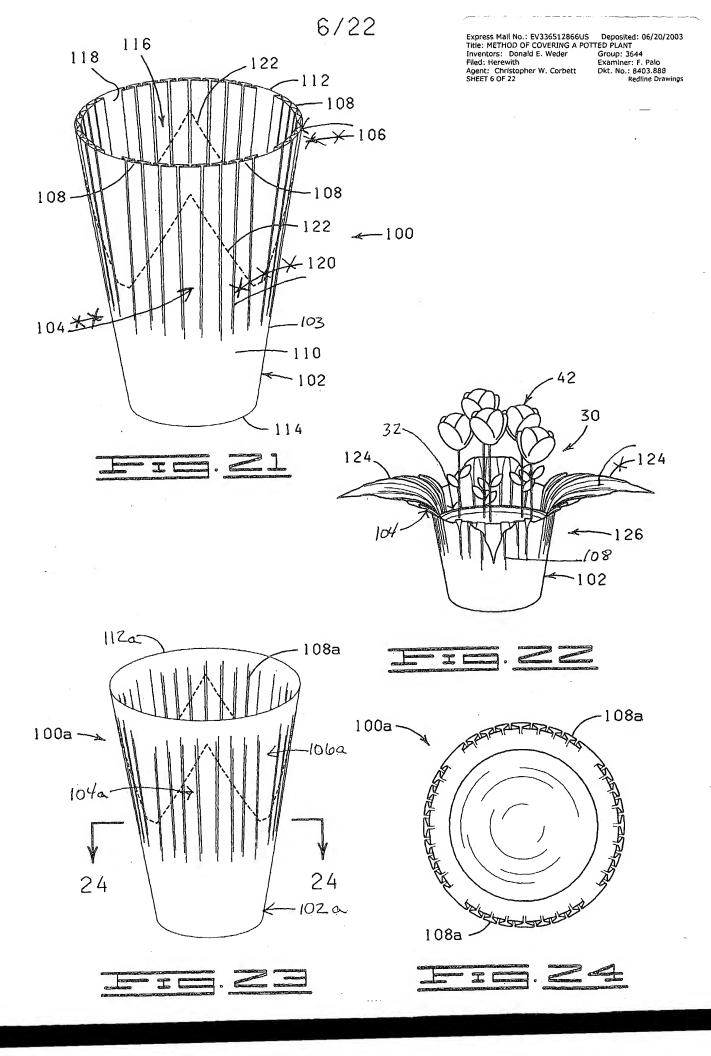


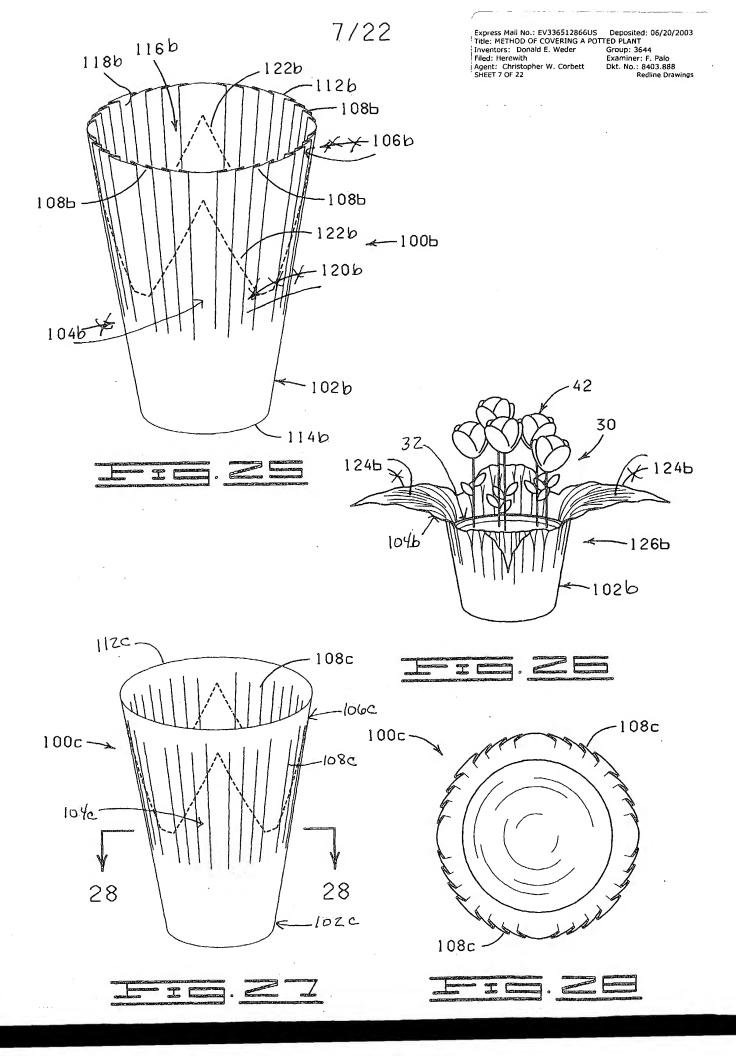

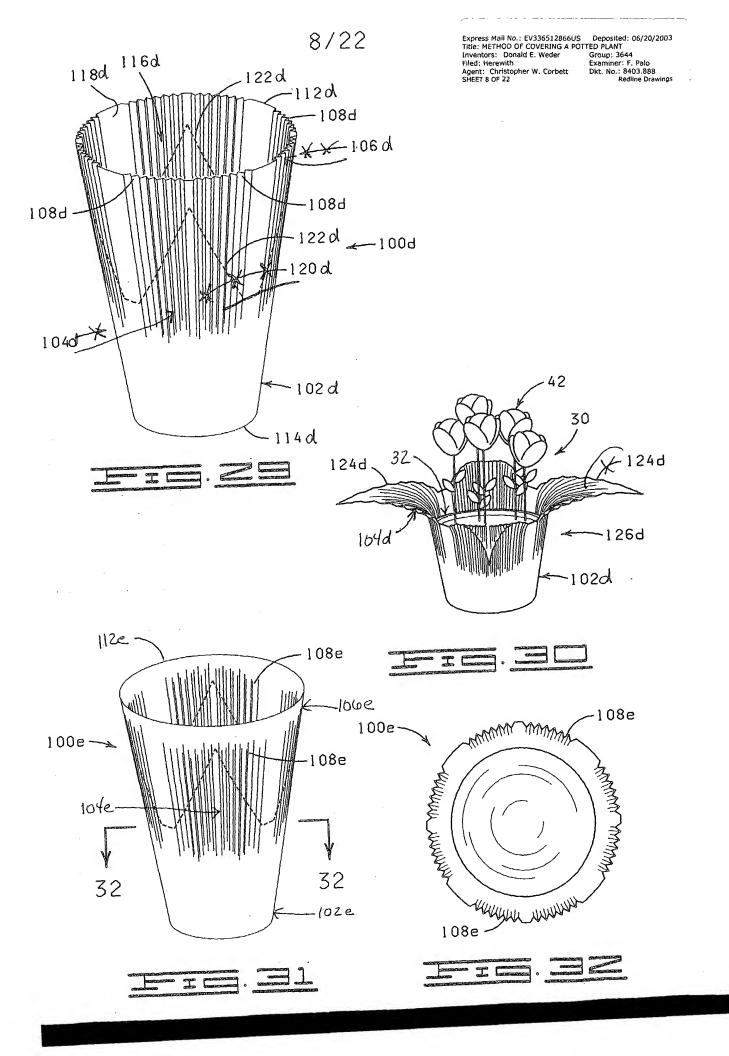

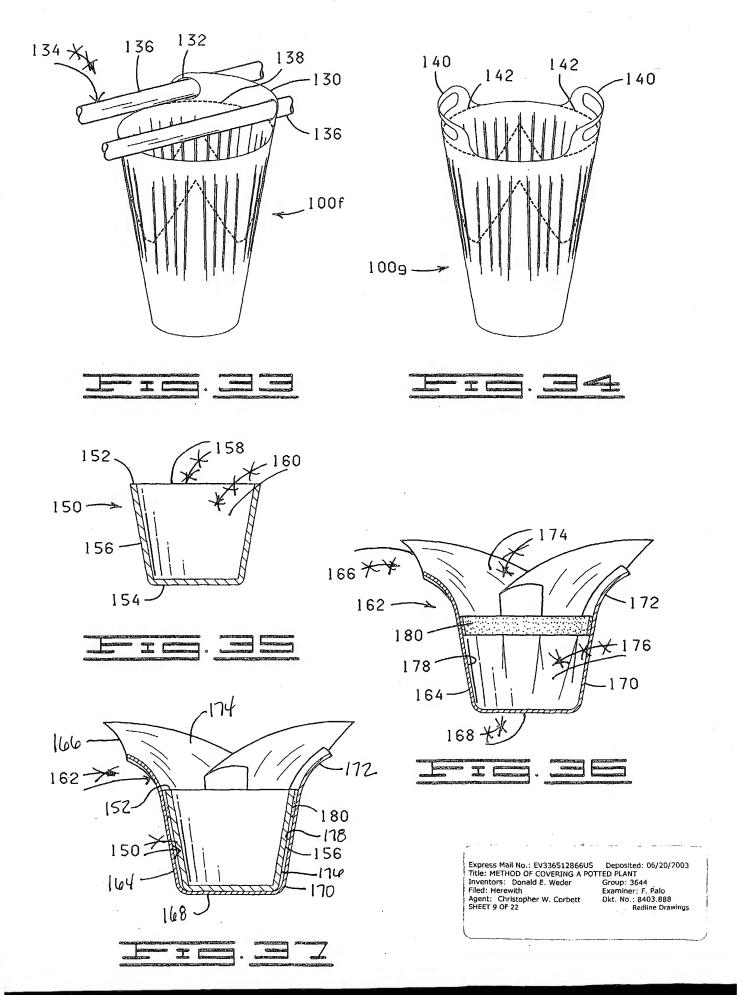

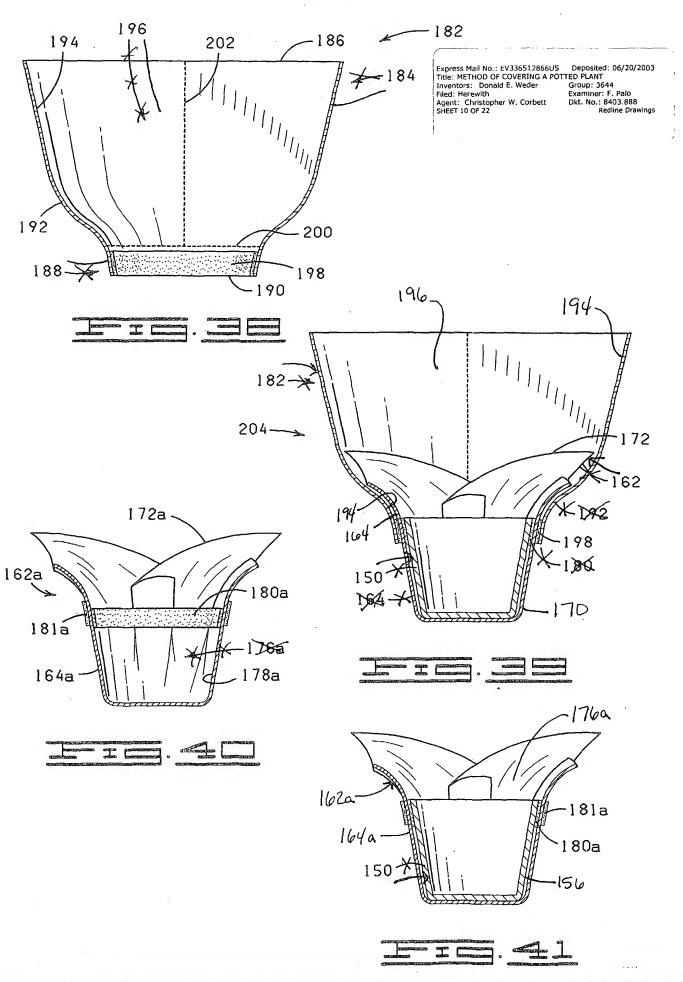

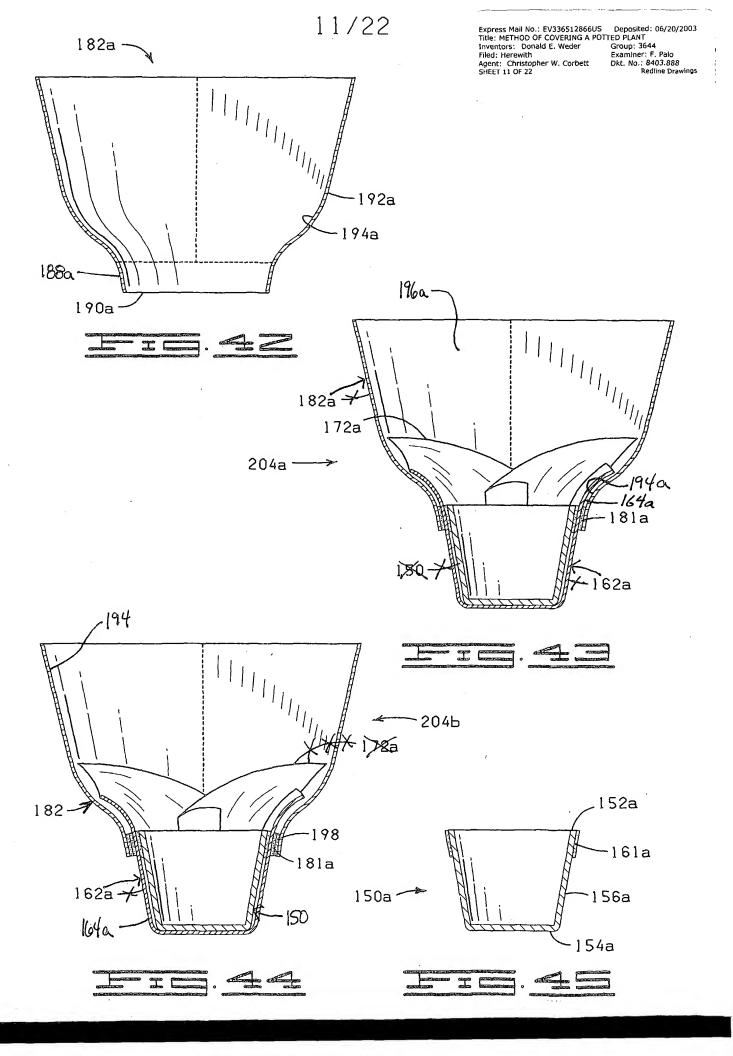


Express Mail No.: EV336512866US Deposited: 06/20/2003
Title: METHOD OF COVERING A POTTED PLANT
Inventors: Donald E. Weder
Filed: Herewith Examiner: F. Palo
Agent: Christopher W. Corbett SHEET 12 OF 22 Redline Drawings


172Ь

170Ь




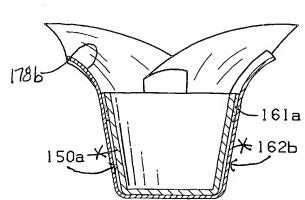




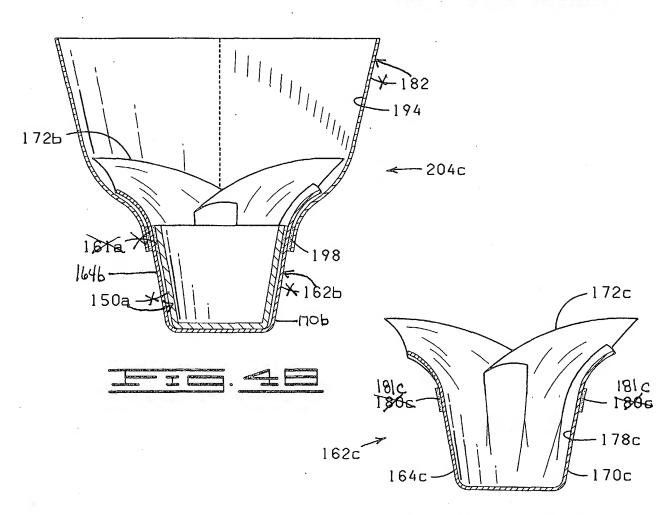




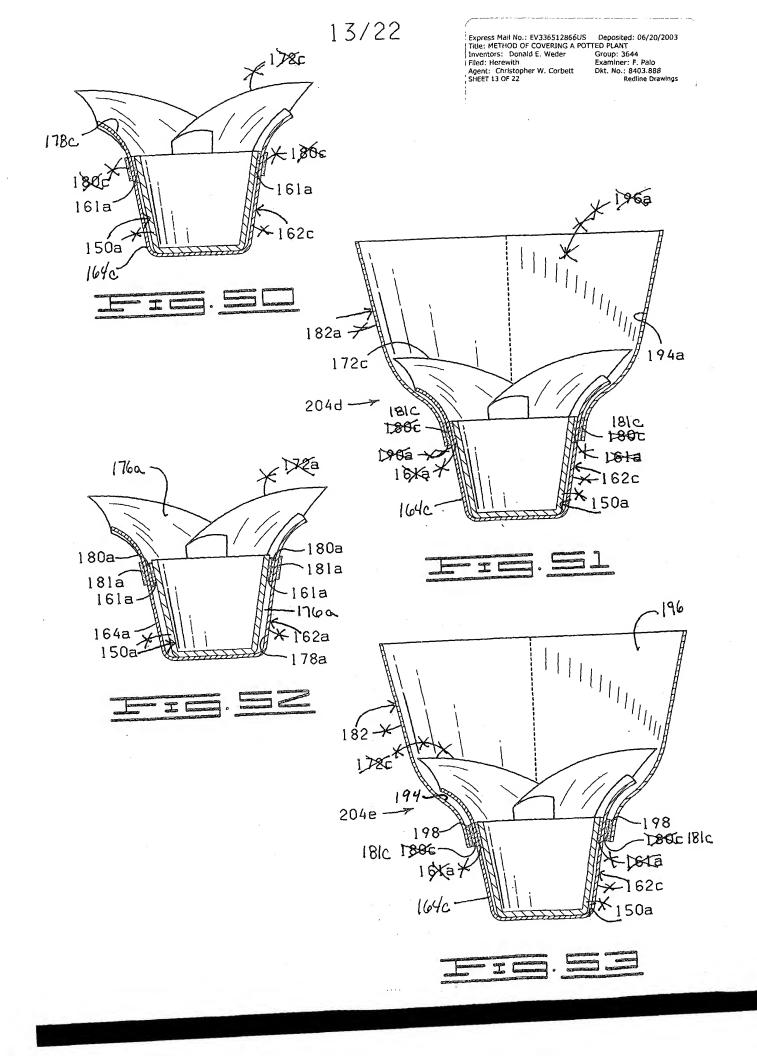


Express Mail No.: EV336512866US Deposited: 06/20/2003
Title: METHOD OF COVERING A POTTED PLANT
Inventors: Donald E. Weder Group: 3644
Filed: Herewith Agent: Christopher W. Corbett SHEET 14 OF 22 Redline Drawings

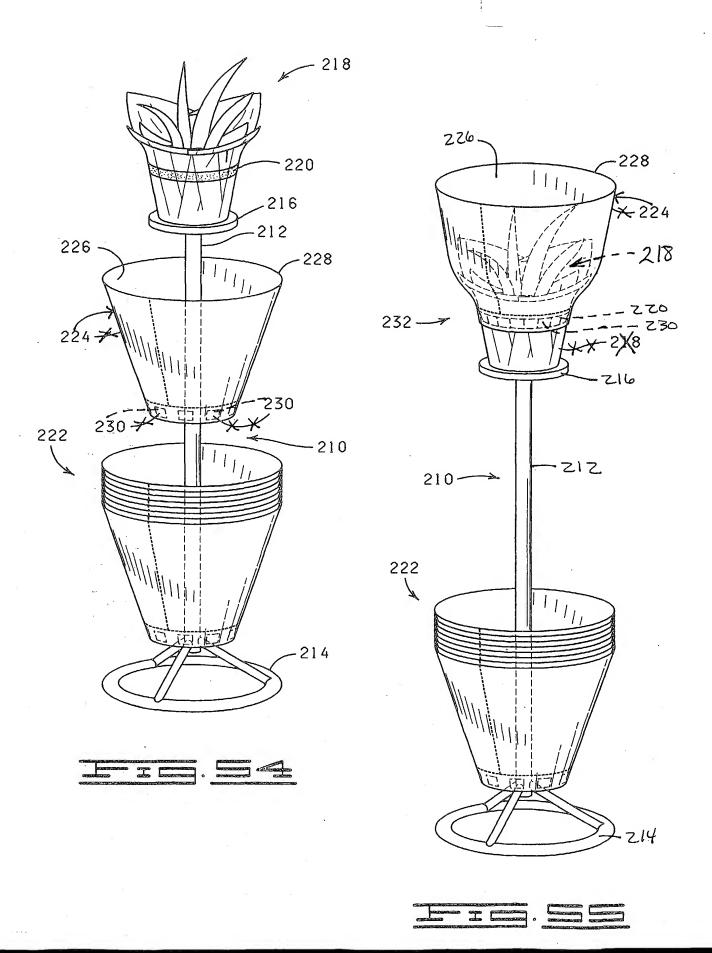



Express Mail No.: EV336512866US Deposited: 06/20/2003
Title: METHOD OF COVERING A POTTED PLANT
Inventors: Donald E. Weder
Filed: Herewith Agent: Christopher W. Corbett
SHEET 15 OF 22 Redline Drawings

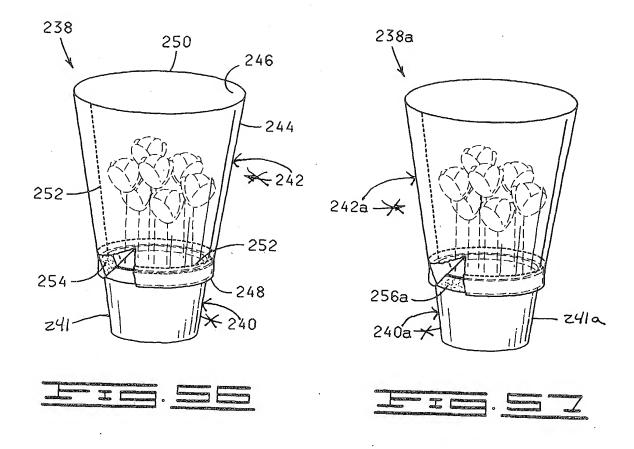


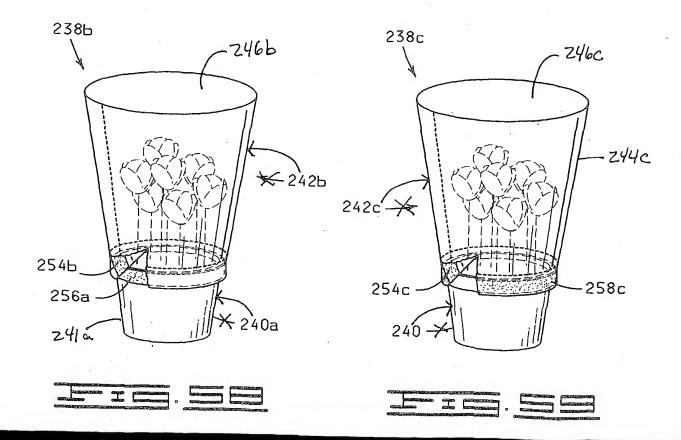


Express Mail No.: EV336512866US Deposited: 06/20/2003
Title: METHOD OF COVERING A POTTED PLANT
Inventors: Donald E. Weder
Filed: Herewith Agent: Christopher W. Corbett
SHEET 16 OF 22 Deposited: 06/20/2003
Title: METHOD OF COVERING A POTTED PLANT
Group: 3644
Examiner: F. Palo
Dkt. No.: 8403.888
Redline Drawings

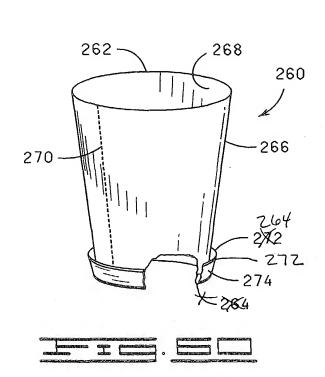

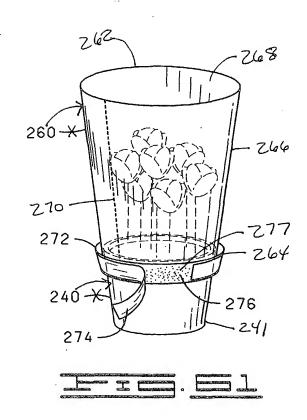

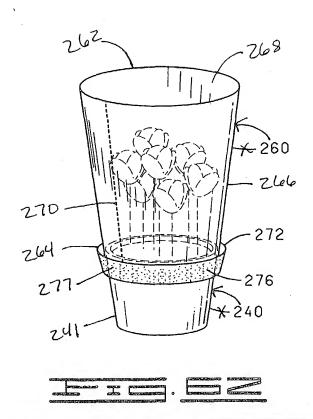

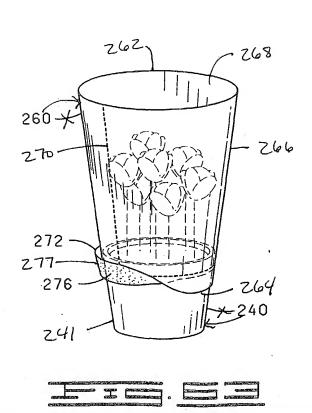

Express Mail No.: EV336512866US Deposited: 06/20/2003
Title: METHOD OF COVERING A POTTED PLANT
Inventors: Donald E, Weder
Filed: Herewith Agent: Christopher W. Corbett
SHEET 17 OF 22 Deposited: 06/20/2003
Group: 3644
Examiner: F, Palo
Dkt. No.: 8403.888
Redline Drawings

